

# PARAMOUNT REAL ESTATE CORPORATION

## **FOR LEASE**

## Flex Building Minnetonka, Minnesota



### **CONTACTS:**

Nancy Powell (952) 854-9210 npowell@paramountre.com

#### **WEBSITE:**

www.paramountre.com

#### **ADDRESS:**

3601 Minnesota Drive Suite 925 Bloomington, MN 55435 (952) 854-8290

#### FAX:

(952) 854-8295



### RMC CORPORATE CENTER

10901-10955 Bren Road East Minnetonka, Minnesota

### **FEATURES:**

- Easy freeway access to Highway 169, Crosstown 62 and I-494
- Extensive glass lines
- ▶ Overlooking wetlands and adjacent to walk/bike path
- ► All office, office/showroom and office/warehouse suites
- Many nearby amenities, including restaurants and hotels

### **BUILDING SPECIFICS:**

- ► 73,529 square foot flex facility
- ► Divisible for multiple tenants
- ► 14' clear height
- ► 177 parking stalls (2.4/1000)
- ► Fully sprinklered
- Local ownership and responsive, professional property management





## **RMC CORPORATE CENTER**

10901-10955 Bren Road East | Minnetonka, MN



3601 Minnesota Drive Suite 925 Bloomington, MN 55435

952-854-8290 • FAX 952-854-8295

www.paramountre.com



### **CONTACTS:**



Nancy Powell (952) 854-9210 npowell@paramountre.com





## **FOR LEASE**

## **RMC CORPORATE CENTER**

### 10901-10955 Bren Road East Minnetonka, MN

<b>AVAILAB</b>	LE
<b>SQUARE</b>	FEE

QUARE FEET:	<u>OFFICE</u>	<u>WAREHOUSE</u>	<u>TOTAL</u>
Suite 10951:	2,210 sq. ft.	900 sq. ft.	3,110 sq. ft.
Suite 10901-10913 Combinations:			
Suite 10901/10905/10913:	21,184 sq. ft.	1,594 sq. ft.	22,778 sq. ft.
Suite 10905/10913:	15,741 sq. ft.	1,594 sq. ft.	17,335 sq. ft.
Suite 10901/10905:	12,635 sq. ft.	1,594 sq. ft.	14,229 sq. ft.
Suite 10913 (with warehouse):	8,549 sq. ft.	1,594 sq. ft.	10,143 sq. ft.
Suite 10913:	8,549 sq. ft.		8,549 sq. ft.
Suite 10901:	5,443 sq. ft.		5,443 sq. ft.

**BUILDING SIZE:** 73,529 square feet total

**NET RENTAL RATES:** \$9.50 per sq. ft. for Office

\$4.50 per sq. ft. for Warehouse

2019 EST. OPERATING

**EXPENSES & TAX:** \$4.19 per square foot

**LOADING:** Suite 10901-10913 –Two (2) docks, one (1) drive-in (ramped)

Suite 10951 – One (1) drive-in (ramped)

**PARKING:** 177 stalls (2.41/1000)

CLEAR HEIGHT: 14'

**COMMENTS:** Easy freeway access to Highway 169, Crosstown 62 and

Interstate 494

► Approximate 2,500 SF data center with raised floors, fire

suppression & backup generator

► Extensive glass lines

► Park like setting near walking path

► Many nearby amenities

#### For further information contact:


PARAMOUNT REAL ESTATE CORP | TCN WORLDWIDE Nancy Powell | Vice President (952) 854-9210

Email: npowell@paramountre.com

## **FOR LEASE**

## **RMC CORPORATE CENTER**


10901-10955 Bren Road East Minnetonka, MN

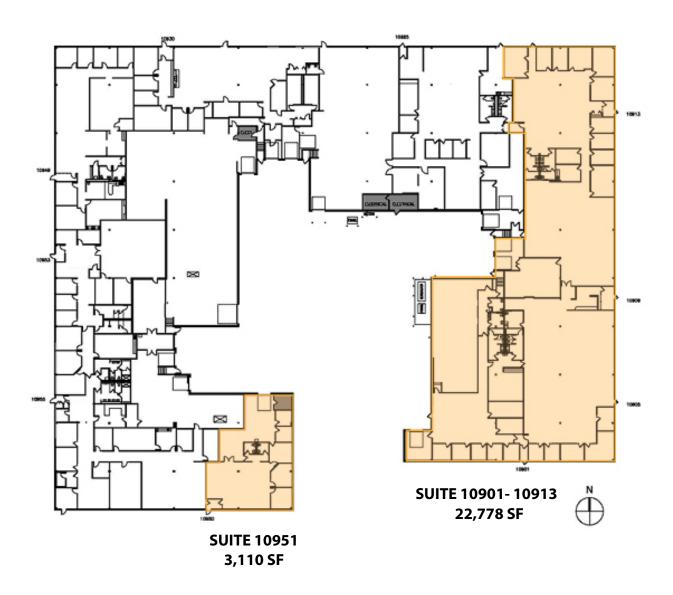



Nancy Powell | 952-854-9210 | npowell@paramountre.com



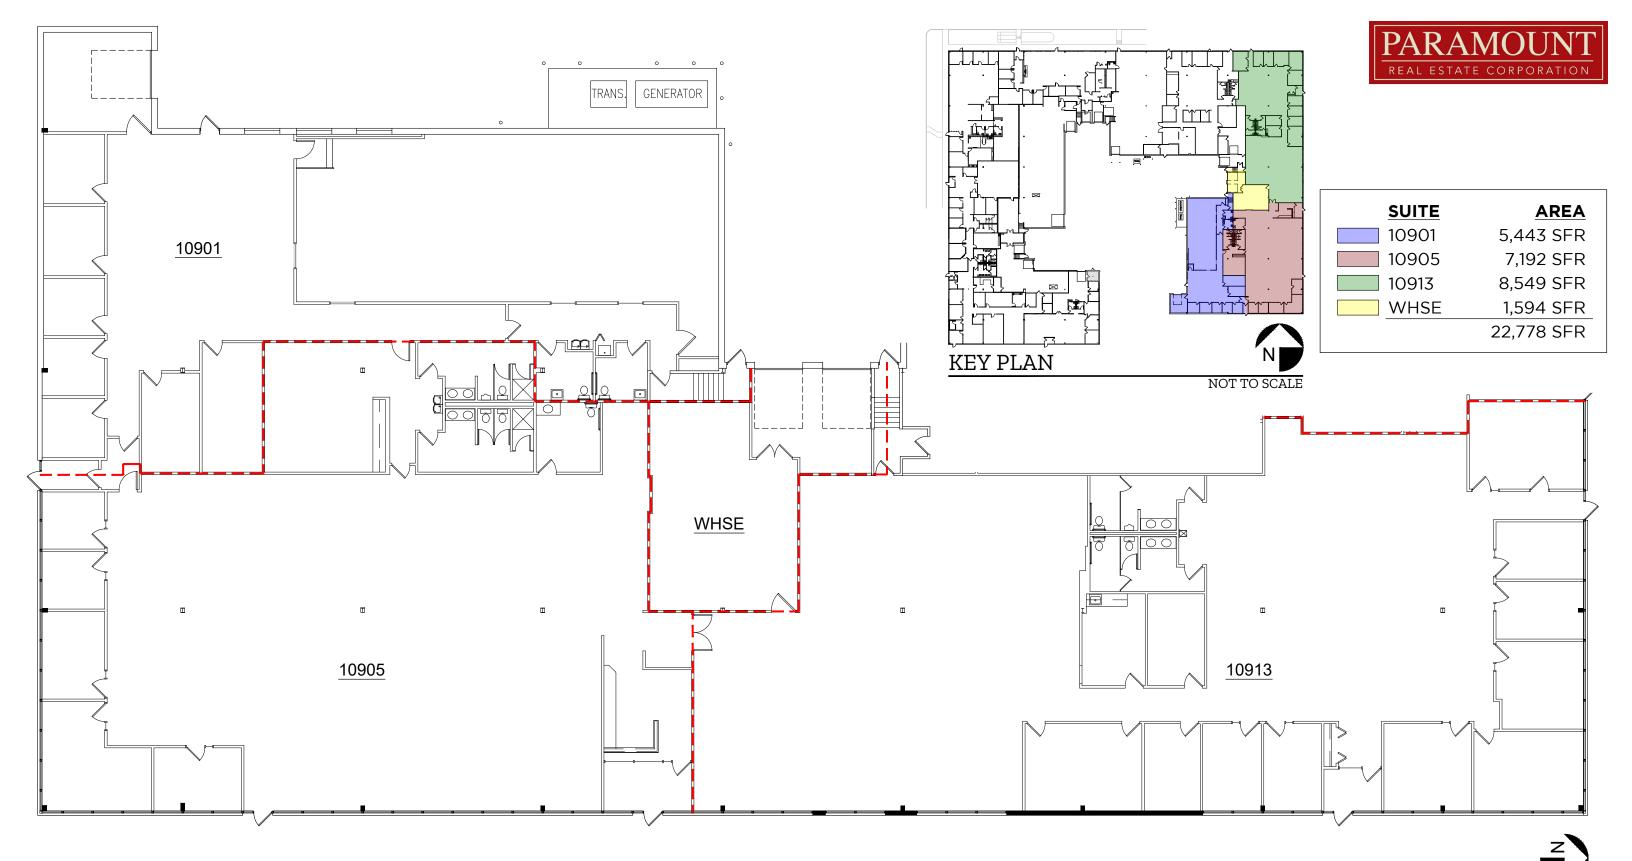

FLOOR PLAN

SCALE: 1/16" = 1'-0"


As-Built 11-20-18



## FOR LEASE


## **RMC CORPORATE CENTER**

10901-10955 Bren Road East | Suite 10951 Minnetonka, MN

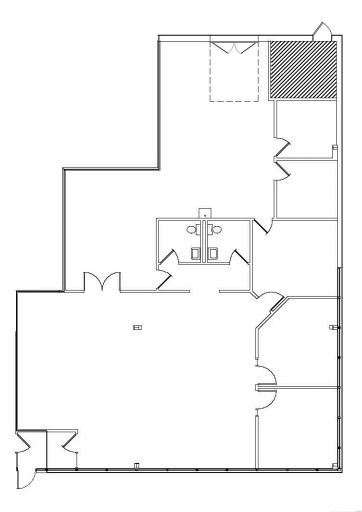



Suite 10951 2,210 SF Office 900 SF Warehouse 3,110 SF Total

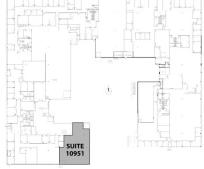

For more information please contact:

Nancy Powell | 952-854-9210 | npowell@paramountre.com

