SUITE 400 - 3,504 RSF

AMTRUST BANK PLAZA
8211 W. Broward Blvd.
Plantation, FL 33324

ALFIE HAMILTON
954 453 6050 direct
alfie.hamilton@colliers.com

CAITLIN INKLEBARGER
954 453 6055
caitlin.inklebarger@colliers.com

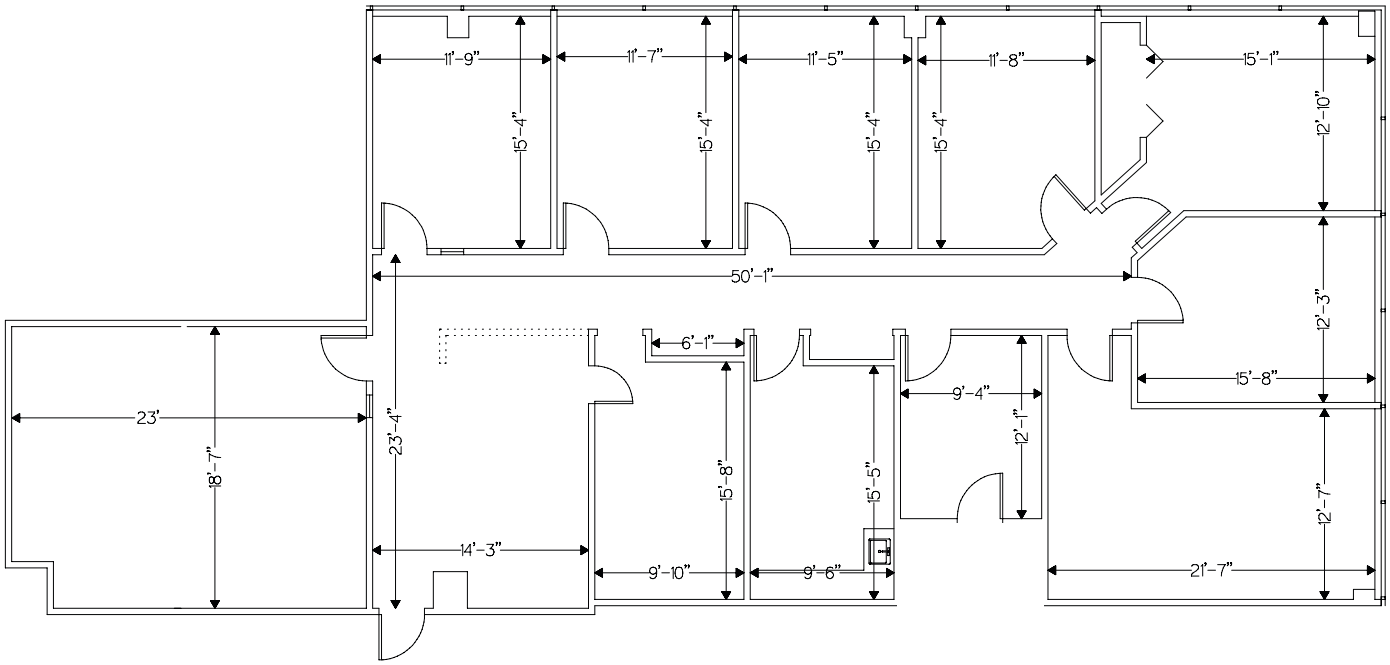

AS BUILT PLAN

COLLIERS INTERNATIONAL
SOUTH FLORIDA, LLC
13218 W. Broward Blvd.
Plantation FL 33325

tel +1 954 727 9335
fax +1 954 727 9938
www.colliers.com

Accelerating success.